

1

# APPLICATION FOR PERMIT

COUNTY OF LOS ANGELES  
DEPARTMENT OF COUNTY ENGINEER  
BUILDING AND SAFETY DIVISION

## SEWER-SEWAGE DISPOSAL

### FOR APPLICANT TO FILL IN

LEGAL DESCRIPTION	LOT NO. 148.99.3 of 144 W 20' of 1.49.5 of 15' 27-28	
BLOCK	TRACT	
SIZE OF LOT	NO. OF BLDGS. NOW ON LOT	
USE OF BUILDINGS	DEMOLISH	
CONTRACTOR	COLIMAN WRECKING CO.	
ADDRESS	4572 E. 57th ST	
CITY	L.A. TEL. NO. 261-5746	
STATE LICENSE NO. 279112	LIC CLASS C-21	
NO.	DESCRIPTION OF WORK	FEE
	HOUSE SEWER CONNECTING TO PUBLIC SEWER	@ \$7.00
	SEPTIC TANK, SEEPAGE PIT OR PITS AND/OR DRAINFIELD	@ \$10.00
	HOUSE SEWER CONNECTING TO PRIVATE DISPOSAL SYSTEM	@ \$3.00
	CONNECT ADDITIONAL BLDG. OR WORK TO HOUSE SEWER	@ \$3.00
	OVERFLOW SEEPAGE PIT, DRAINFIELD EXTN., CESSPOOL, DRYWELL.	@ \$5.00
1	ALTER, REPAIR OR ABANDON HOUSE SEWER OR DISPOSAL SYSTEM	@ \$3.00
	MANHOLE	@ \$7.00

OWNER'S AUTHORIZATION	PERMIT	\$	3	00
	TOTAL FEE		6	00

I HAVE AT THIS DATE A CONTRACT WITH THE HEREIN NAMED CONTRACTOR TO CONNECT THE ABOVE DESCRIBED EXISTING DWELLING TO THE PUBLIC SEWER.  
SIGNED THIS 15 DAY OF SEP 1973  
OWNER OR OWNERS AGENT George Perry  
ADDRESS 4572 E. 57th ST L.A.

I HEREBY ACKNOWLEDGE THAT I HAVE READ THIS APPLICATION AND STATE THAT THE ABOVE IS CORRECT AND AGREE TO COMPLY WITH ALL COUNTY ORDINANCES AND STATE LAWS REGULATING PLUMBING AND SEWERS.

I HEREBY CERTIFY THAT I AM PROPERLY REGISTERED AND/OR LICENSED AS REQUIRED BY LOS ANGELES COUNTY AND STATE OF CALIFORNIA OR THAT I AM THE LEGAL OWNER OF, AND INTEND TO RESIDE IN, THE ABOVE DESCRIBED RESIDENTIAL PROPERTY.

SIGNATURE OF PERMITTEE George Perry

BUILDING ADDRESS	111-115 N. Eastern Ave
LOCALITY	E. LOS ANGELES CALIF.
NEAREST CROSS ST.	6. FIRST ST.
OWNER	MARCUS ROSE ASPECTIA
MAIL ADDRESS	2552 V.A. CORONA AVE
CITY	MONTEBELLO TEL. NO.

DISTRICT NO.	GROUP	BK	MAP	PS	PROCESSED BY
6	I	G	86		Fohman

### CONNECTION DATA

STATION	5+09.7	DEPTH	<del>8</del>
MANHOLE REFERENCE	76.6' N. of	UPPER LOWER	
TYPE OF CONNECTION	CURB	P.L.	LENGTH FROM M.L. TO P.L.
CO. IMP. NO.		P.C. NO.	JOB NO.
TRUNK PERMIT NO.		ROAD PERMIT NO.	
AFFIDAVIT	WAIVER	EASEMENT	RECORD. INSTR. NO. DATE
HWY. OR ST. WIDENING			
STATE ENCROACHMENT PERMIT NO.	Card #37359		
INDUSTRIAL WASTE APPROVAL			

CHARGES
CONNECTION CHARGE FEE
REIMBURSEMENT FEE

APPROVALS	DATE	INSPECTOR'S SIGNATURE
NEW HOUSE SEWER		
CONNECT ADDITIONAL BUILDING OR WORK		
SEPTIC TANK, SEEP, PIT(S) AND/OR DRAINFIELD		
CESSPOOL <input type="checkbox"/> DRYWELL <input type="checkbox"/>		
ALTER, REPAIR, SEWER OR SEWAGE DISPOSAL SYSTEM		
DISCONNECT PLUG AND ABANDON HOUSE SEWER		
BACKFILL SEPTIC TANKS <input type="checkbox"/> SEEP, PIT(S) <input type="checkbox"/> CESSPOOLS <input type="checkbox"/>		

VALIDATION

CK. M.O. CASH

INSPECTOR COPY

9922SEP 1510 A


6.00-99

Recd. \$40.00 chg. 750 \$/Permits

FOR DEPARTMENT USE

REQUIRED INFORMATION

1. INDICATE ALL BUILDINGS ON PROPERTY.
2. INDICATE AND DIMENSION SEWAGE DISPOSAL SYSTEM WITH TIE DISTANCES TO BUILDINGS AND PROPERTY LINES.
3. INDICATE SIZE OF SEPTIC TANK-DEPTH OF SEEPAGE PIT(S)-SIZE OF CESSPOOL(S).
4. INDICATE NORTH DIRECTION ON PLOT.
5. INDICATE BOTH STREETS IF CORNER.

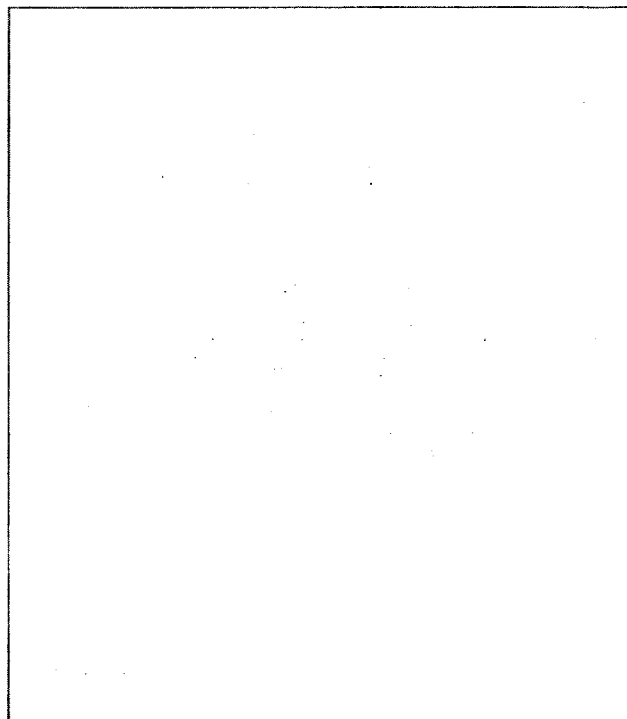

ST. ALLEY R/W

FIELD NOTES